


STATO DI FORNITURA  
(SUPPLY CONDITION)


SCALA NON IMPEGNATIVA  
(DO NOT SCALE)  
DIMENSIONI IN mm  
(DIMENSIONS IN)

METRIC

PROIEZIONE EUROPEA  
(EUROPEAN PROJECTION)

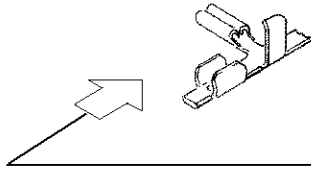

SENSO DI USCITA DEL TERMINALE  
DALLA BOBINA  
(DIRECTION OFF TOP OF REEL)

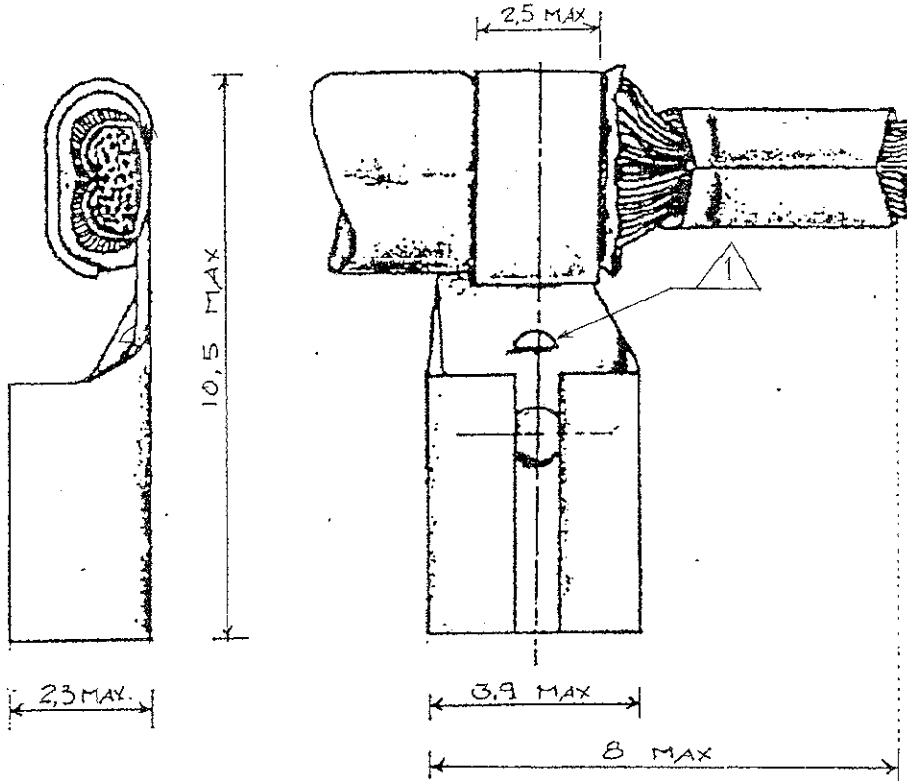

1 VERSIONE SENZA BUGNA, RISERVATA AL CLIENTE TRW ITALIA.  
(NO TAB STOP VERSION. RESTRICTED FOR CUSTOMER TRW ITALIA).

2 OBSOLETE PARTS: OBSOLETE CIS STREAMLINING PER D.RENAUD/D.SINISI

|      |   |                    |  |                          |                       |     |
|------|---|--------------------|--|--------------------------|-----------------------|-----|
| 2    | 1 | 0.43-0.35          | PRESTAGNATO (PRE-TIN PLATED)           | OTTONE (BRASS)           | <del>1-141352-2</del> | R   |
|      |   | 0.71-0.63          | PRESTAGNATO (PRE-TIN PLATED)           | BRONZO FOSF. (PHOS. BZ.) | 0-141352-6            | R   |
| 2    |   | 0.71-0.63          | NUDO (PLAIN)                           | BRONZO FOSF. (PHOS. BZ.) | <del>0-141352-5</del> | R   |
|      |   | 0.71-0.63          | PRESTAGNATO (PRE-TIN PLATED)           | OTTONE (BRASS)           | 0-141352-4            | R   |
|      |   | 0.71-0.63          | NUDO (PLAIN)                           | OTTONE (BRASS)           | 0-141352-3            | R   |
|      |   | 0.43-0.35          | PRESTAGNATO (PRE-TIN PLATED)           | OTTONE (BRASS)           | 0-141352-2            | R   |
|      |   | 0.43-0.35          | NUDO (PLAIN)                           | OTTONE (BRASS)           | 0-141352-1            | R   |
| NOTE |   | LUCE<br>(GAP SIZE) | FINITURA / COLORE<br>(FINISH / COLOUR) | MATERIALE<br>(MATERIAL)  | NUMERO<br>(CAMP P/ND) | REV |

CUSTOMER DWG.  
FOR REFERENCE ONLY

DISEGNO PER CLIENTE  
SOLO PER RIFERIMENTO

THIS DRAWING IS UNPUBLISHED - RELEASE FOR PUBLICATION 19  
© COPYRIGHT 19 BY AMP INCORPORATED, HARRISBURG, PA. ALL INTERNATIONAL RIGHT RESERVED. AMP PRODUCTS MAY BE COVERED BY U.S. AND FOREIGN PATENT AND/OR PATENT PENDING

TOLLERANZE, SE NON DIVERSAMENTE SPECIFICATO  
(TOLERANCES, UNLESS OTHERWISE SPECIFIED)

|                                     |                            |                  |
|-------------------------------------|----------------------------|------------------|
| DIAM. ISOLANTE<br>(INS. DIA. RANGE) | RANGO FILO<br>(WIRE RANGE) | SCALA<br>(SCALE) |
| 1.6-2.5 mm                          | mm <sup>2</sup> 0.3-0.8    | -                |

|                     |                                   |              |                |                           |               |   |
|---------------------|-----------------------------------|--------------|----------------|---------------------------|---------------|---|
| R4                  | ECR-10-011338                     | PKS          | 27MAY10        | ANGOLI<br>(ANGLES)        | ± 0.3<br>± 2° | <p>TE ITALIA S.p.A.<br/>Corso F.lli Cervi, 15<br/>COLLEGNO (TORINO)</p> |
| R3                  | ECO-10-000030                     | KK           | 05JAN10        | DIS. H. YAALI<br>(DR.)    | 20 MAY 99     |   |
| R2                  | ADDED NEW PART<br>ET00-0085-03    | H.Y.         | 29 MAY 03      | CONT. C. TARTARI<br>(CHK) | 20 MAY 99     | DESCRIZIONE<br>(DESCRIPTION)  |
| R1                  | ADDED DIMENSION<br>ET00-0247-01   | H.Y.         | 12 OCT 01      |                           |               | FASTON Connector<br>.110 sr. FLAG REC. CTC.                             |
| P                   | REVISED & REDRAWN<br>ET00-0176-99 | H.Y.         | 01 JAN 99      |                           |               | LOC. SIZE NUMERO<br>(DWG NO)  |
| REV.<br>(REV. LTR.) | REVISIONI<br>(REVISION RECORD)    | DIS.<br>(DR) | DATA<br>(DATE) | APP.<br>(APP.)            |               | I A4 C-141352 R4 1 DI<br>(OF) 1   |

Lead Free Conversion in Process - Refer to  
Specification 230-700 at [www.tycoelectronics.com/leadfree](http://www.tycoelectronics.com/leadfree)

# Mouser Electronics

Authorized Distributor

Click to View Pricing, Inventory, Delivery & Lifecycle Information:

[TE Connectivity:](#)

[141352-4](#)